



Colliers International
1850 Mount Diablo Boulevard, Suite 200
Walnut Creek, CA 94596 | United States
www.colliers.com

LEASING AGENT

Scott Ellis
(925) 279-5575

scott.ellis@colliers.com

Matt Hurd
(925) 279-5567

matt.hurd@colliers.com

North Pointe Technology Centre

4071 Port Chicago Hwy
Concord, CA 94520

Ground Floor

Owned and Managed by

**Sierra Pacific
Properties, Inc.**

Approximate Area Calculations
Subject To Verification:


As-built Plan To Be Verified

This information displayed while not guaranteed has been secured by sources we believe to be reliable. This information is subject to errors & omissions. Any tenant should conduct their own investigation.

Plan Revision - 5-24-18


SUITE 125
2,741 rsf

SUITE 120
3,717 rsf

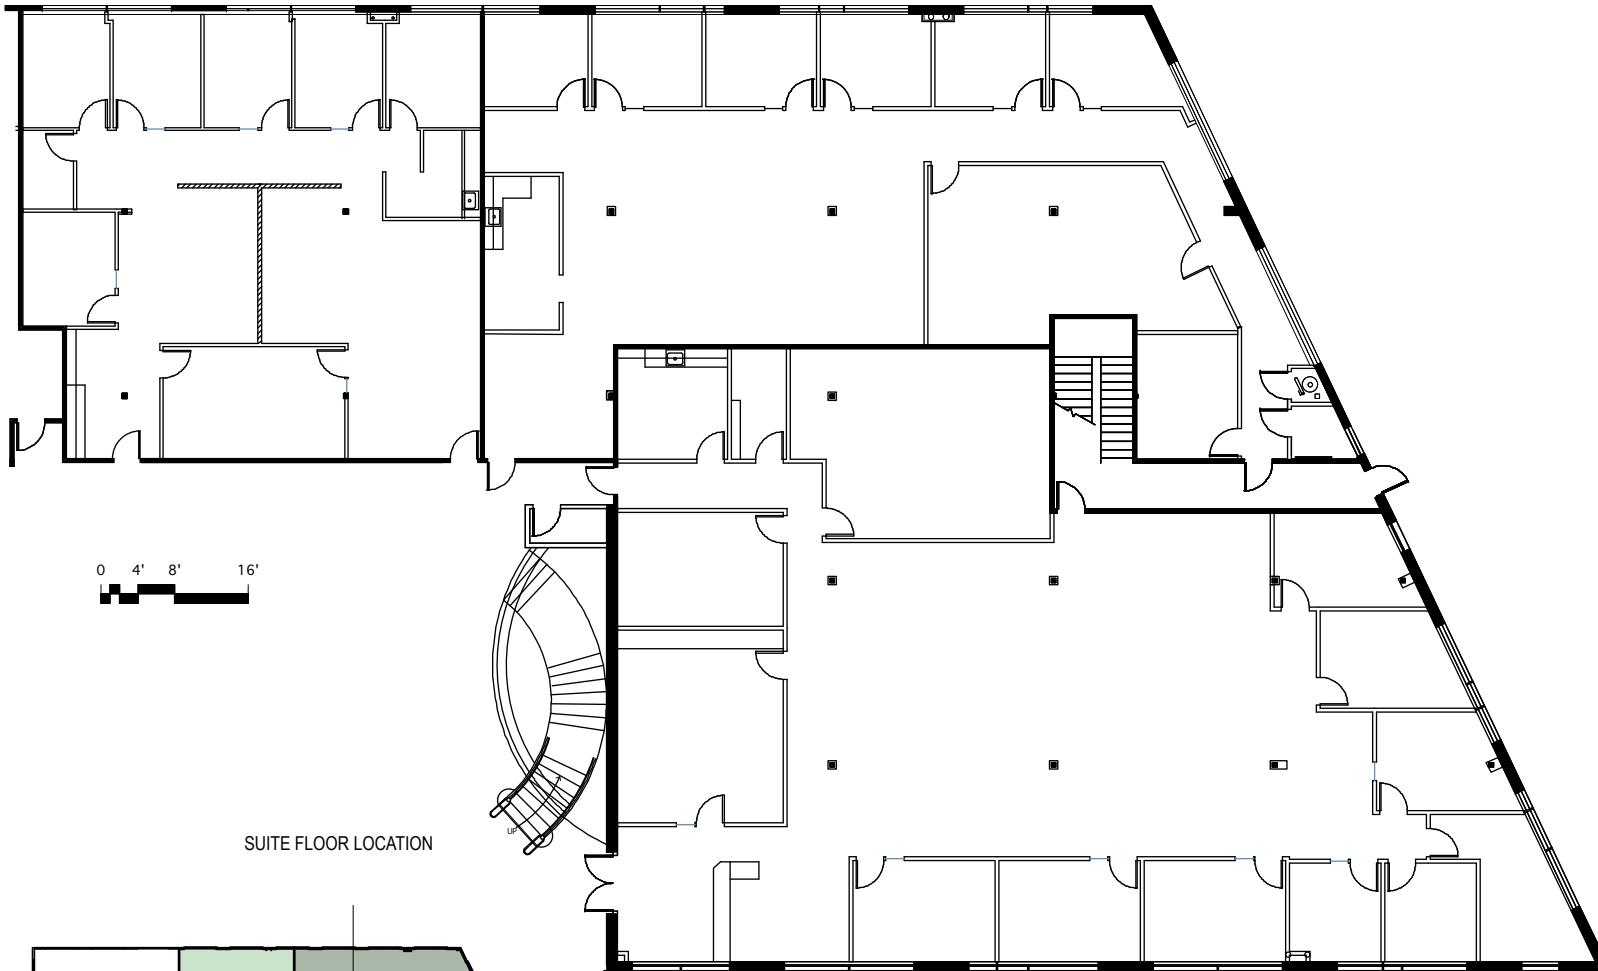

0 4' 8' 16'

SUITE FLOOR LOCATION

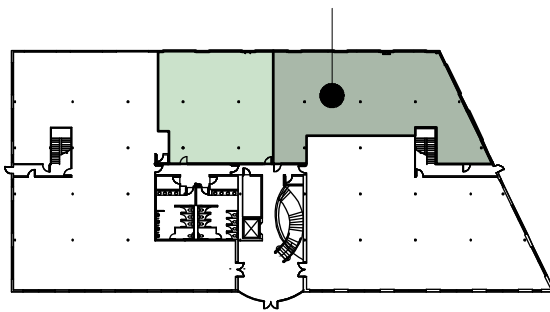

KEY PLAN - GROUND FLOOR

SUITE 130
6,073 rsf