



Colliers International
1850 Mount Diablo Boulevard, Suite 200
Walnut Creek, CA 94596 | United States
www.colliers.com

LEASING AGENT

Matt Hurd
(925) 279-5567

matt.hurd@colliers.com

Scott Ellis
(925) 279-5575

scott.ellis@colliers.com

**Salvio
Pacheco
Square**

2151 Salvio Street
Concord, CA 94520

Third Floor

Owned & Managed by:

**JCM
Partners**

Approximate Area Calculations
Subject To Verification:


2,928 rsf

As-built Plan To Be Verified


This information displayed while not guaranteed
has been secured by sources we believe to be
reliable. This information is subject to errors &
omissions. Any tenant should conduct their own
investigation.

Plan Revision - 2-16-18

SUITE 365

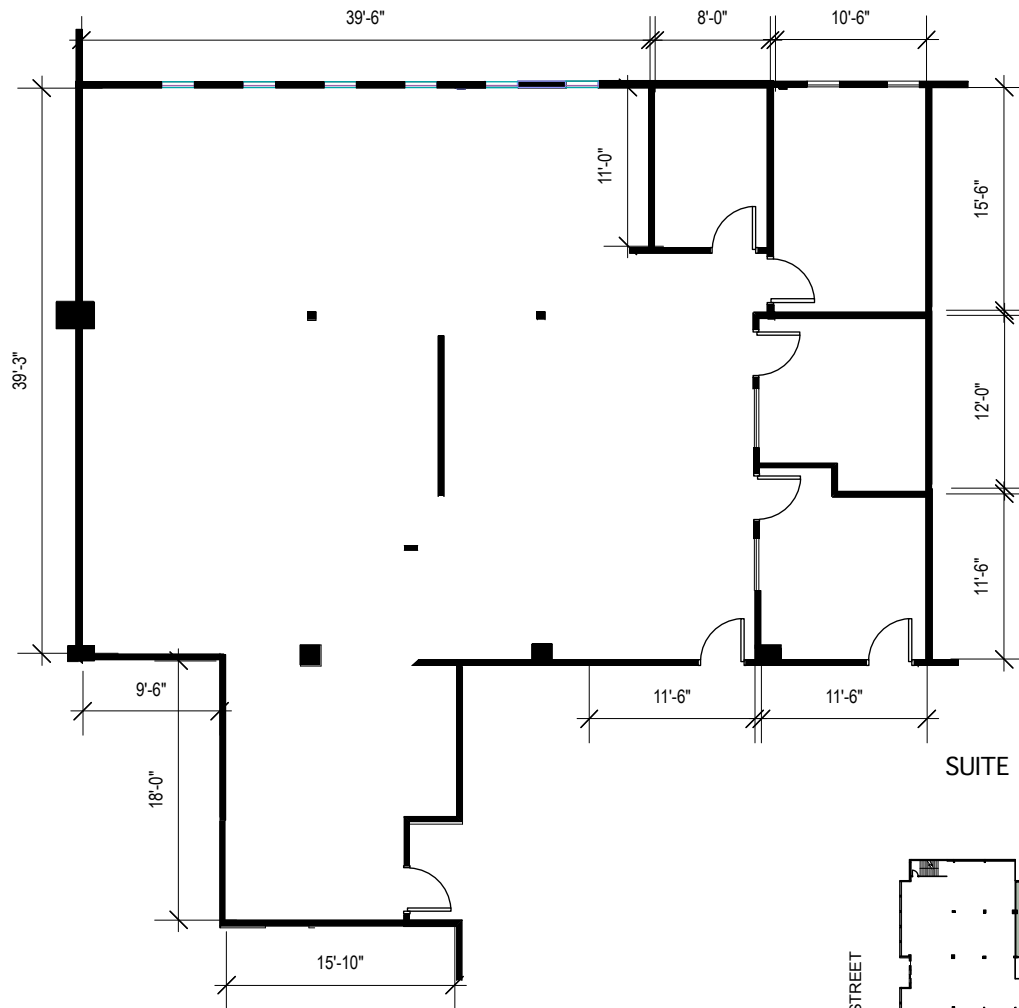

SUITE FLOOR LOCATION

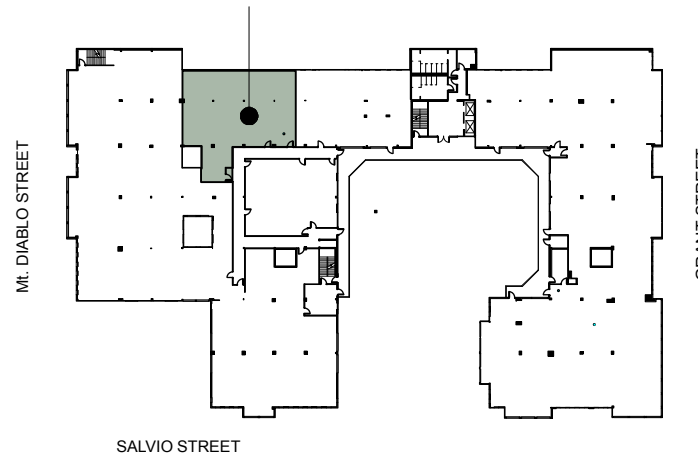

THIRD FLOOR KEY PLAN

"Neither the planner nor the real estate agent warrant the accuracy of the information contained herein. Drawings are for preliminary purposes only and not to be relied upon until confirmed by the furniture vendor and the building architect in the field."